


(1)	Kentec Sigma XT Panel 1pcs
(2)	FireBell (1st Stage Alarm). 2pcs
(3)	Sounder Beacon Flashni 2pcs
(4)	STOP Extinguishing Released FL65 2pcs
(5)	Optical Smoke Detectors 3pcs
(6)	Heat Detectors (ROR) 3kpl
(7)	Abort/Isolation Button (Release Line) 1pcs
(8)	Sequential Activators 2pcs
(9)	FP1200 Ext. Generator (ThermalFuse inside) 3pcs
(10)	FP2000 Ext. Generator (ThermalFuse inside) 1pcs
(11)	Release Button 1pcs
(12)	Connection Box 4pcs

-	-	-	-
-	-	-	-
Asiakas / projekti	Cargotec ASC-nosturi	Piirustuslaji	PALOSUOJAUS / FirePro
-	-	Piirustuksen sisältö	AEROSOLISAMMUTUSLAITTEISTO JÄRJESTELMÄKAAVIO ASC-NOSTURI
FirePro® Finland Oy	www.firepro.fi tel. 010 686 2450 myynti@firepro.fi	Työ no.	Suun. ala
-	-	Piir.no.	Muutos
-	-	Piirt.	JRu
-	-	Suunn.	MVa
-	-	Päiväys	Allekirjoitus
-	-	15.12.2014	-

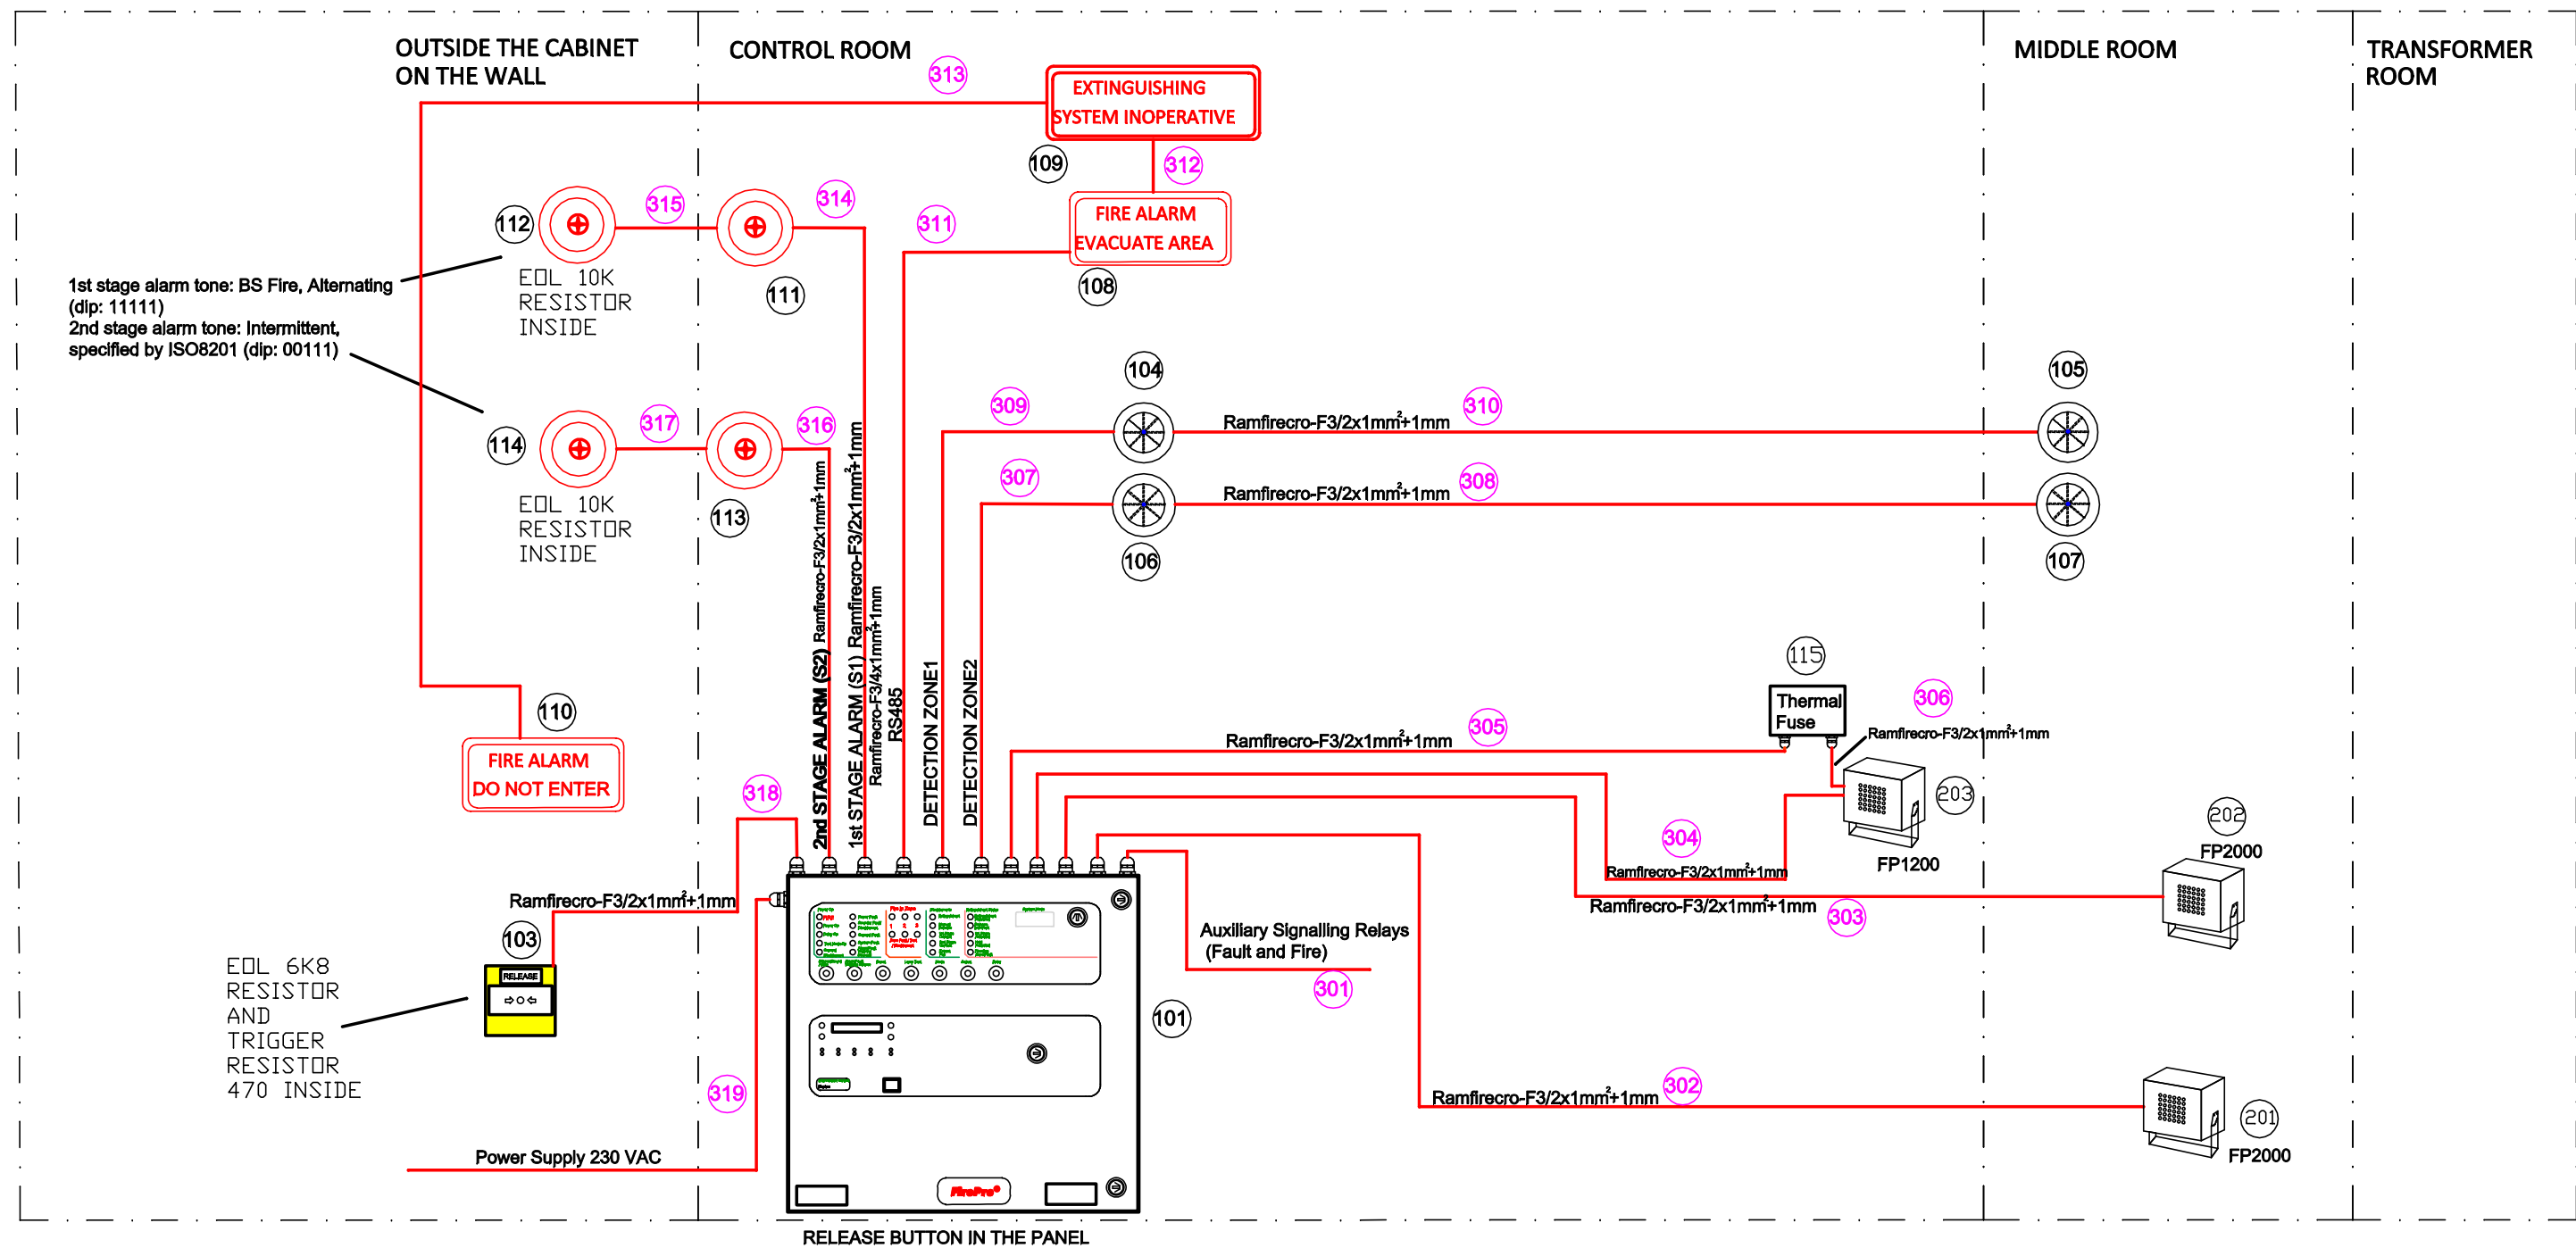


For information of cables, see List of Cables.
 For instructions for the installations, see individual manuals.

(101) Kentec Sigma XT Panel
(103) Release button
(104) Smoke Detector
(105) Smoke Detector
(106) Heat Detector
(107) Heat Detector
(108) FIRE ALARM EVACUATE AREA warning sign
(109) EXTINGUISHING SYSTEM INOPERATIVE warning sign
(110) FIRE ALARM DO NOT ENTER warning sign
(111) Roshni ROLP Siren (IP65), 1st stage sounder
(112) Roshni ROLP Siren (IP65), 1st stage sounder
(113) Roshni ROLP Siren (IP65), 2nd stage sounder

(114) Roshni ROLP Siren (IP65), 2nd stage sounder
(115) Thermal Fuse Assembly
(201) FP2000 Ext. Generator
(202) FP2000 Ext. Generator
(203) FP1200 Ext. Generator

Revision B	Changes FP-1200, Heat Detector and Smoke Detector removed.	Date 29.6.2015	Designer RJa
Client / Project Cargotec ASC-crane		Title AEROSOL FIRE EXTINGUISHING SYSTEM SYSTEM DIAGRAM ASC-CRANE AUSTRALIA	
Drawing no. FP-15-015_B		Change -	
Drawn RJa		Checked MVA	Approved MVA
Date 29.6.2015		Signature	

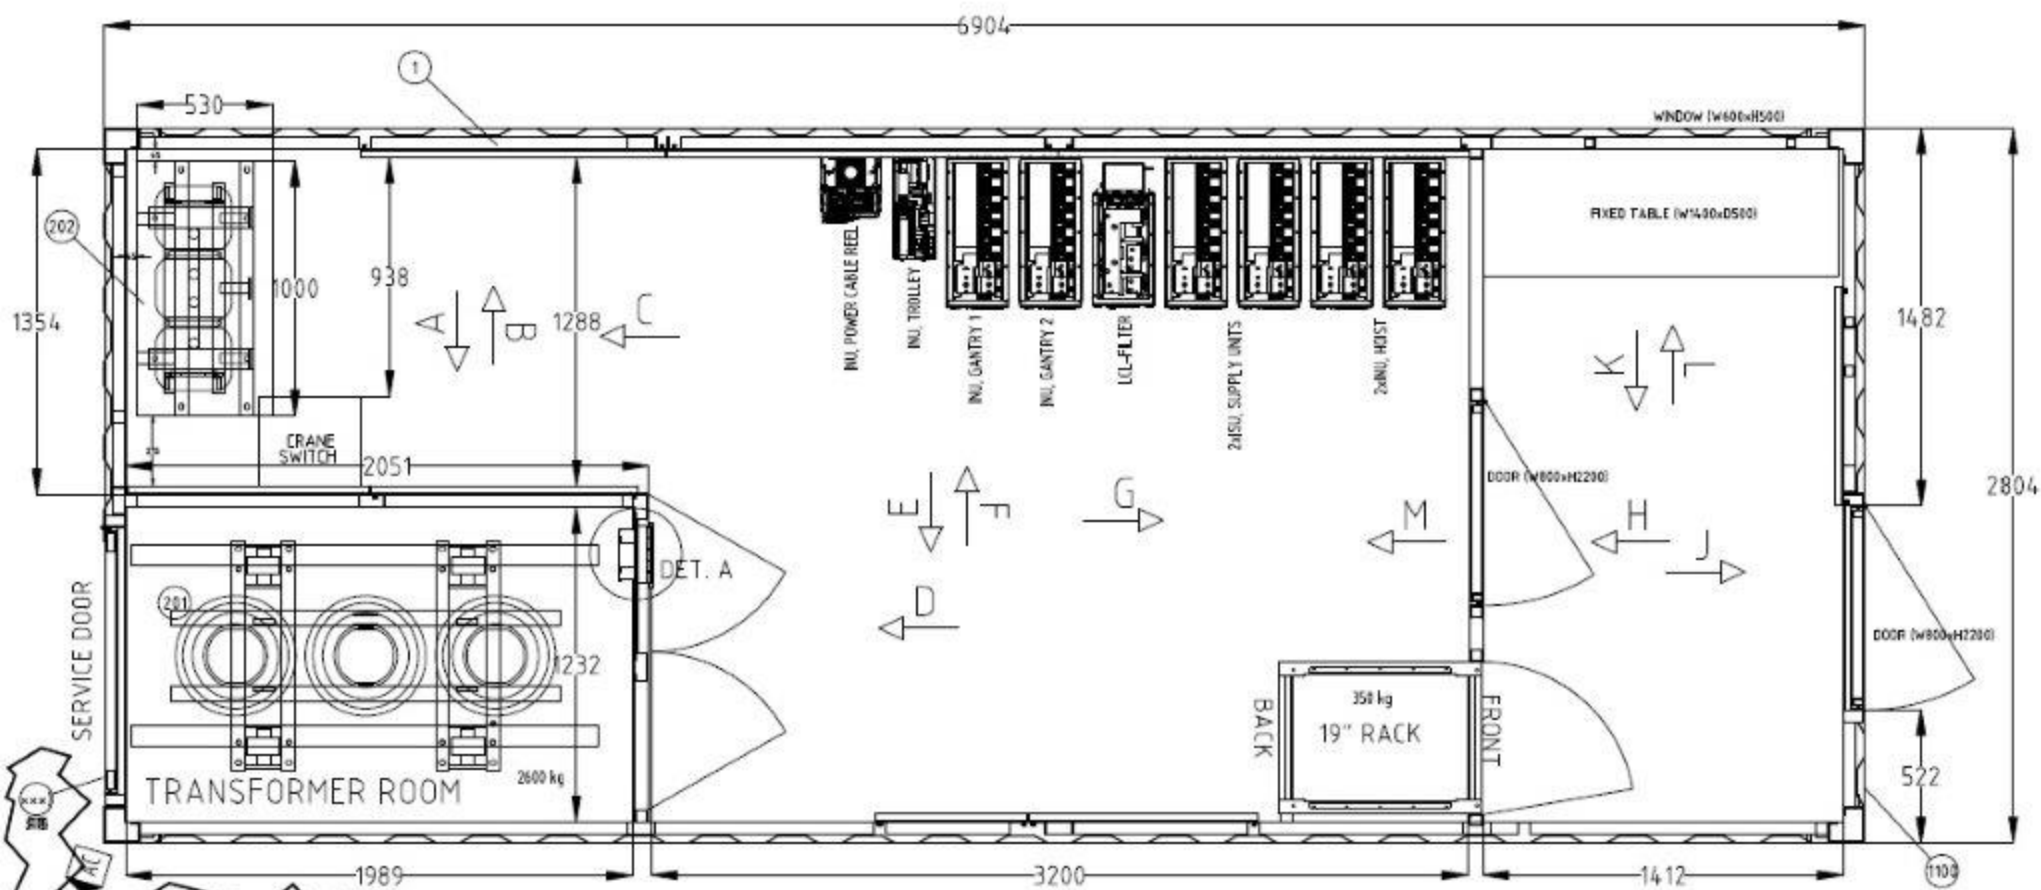

xxx) LOCKS ORDERED IN PROJECT PARTS

FOR DET. A SEE SHEET 17