

FRONT VIEW

REV.	DATE	REVISION DESCRIPTION	DES. APPROVED	CHK. APPROVED	REV.	DATE	REVISION DESCRIPTION	DES. APPROVED	CHK. APPROVED	REFERENCE DRAWING No.	REFERENCE DRAWINGS
A	01/8/17	FIRST ISSUE	W/P S/G	W/P S/G	5	06/07/18	AS BUILT	W/P S/G	FC AT FC	OPR-17-884175	TECHNICAL OFFER - AMR - METSO
0	06/8/17	ISSUED FOR CONSTRUCTION	W/P S/G	W/P S/G	6	08/04/19	FIELD CERTIFICATIONS	W/P S/G	W/P S/G		
1	17/8/17	ISSUED FOR CONSTRUCTION	W/P S/G	W/P S/G				W/P S/G	W/P S/G		
2	21/9/17	ISSUED FOR CONSTRUCTION	W/P S/G	W/P S/G				W/P S/G	W/P S/G		
3	09/10/17	ISSUED FOR CONSTRUCTION	W/P S/G	W/P S/G				W/P S/G	W/P S/G		
4	02/04/18	ISSUER COMMENTS	W/P S/G	W/P S/G				W/P S/G	W/P S/G		

**OYU TOLGOI LLC**  
OIOY TOLGOI XXX

ABB Document No. ...

Metso Document No. CCM4759 / PF-121008

ABB Document No. ...

**ELECTROMECHANICAL PROJECT**

METSO LLC - UNDERGROUND CRUSHING

FRONT VIEW

PROJECT NO. ...


CLIENT ...

SCALE ...

DATE ...

SCALE ...

DATE ...

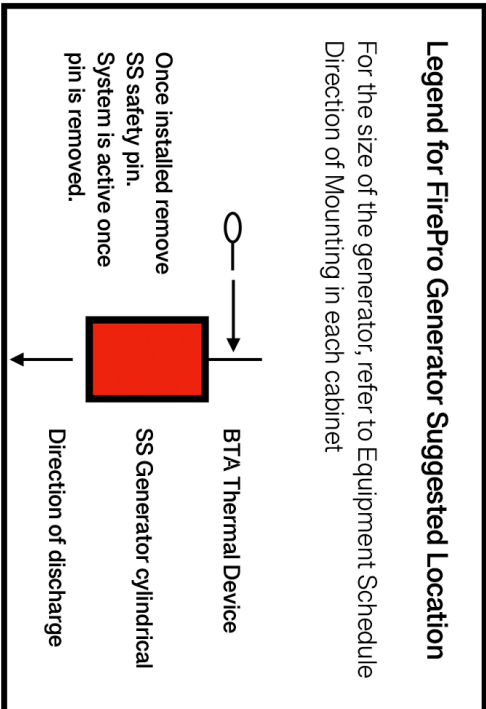

**FirePro Fire Suppression System**  
Suggested Location Layout Per Cabinet  
Fire Safety Equipment  
JAW CRUSHER MCC

DOCUMENT TITLE: ...

REVISION: ...