


MONITORED VIA ADMIN FIP Zone 3

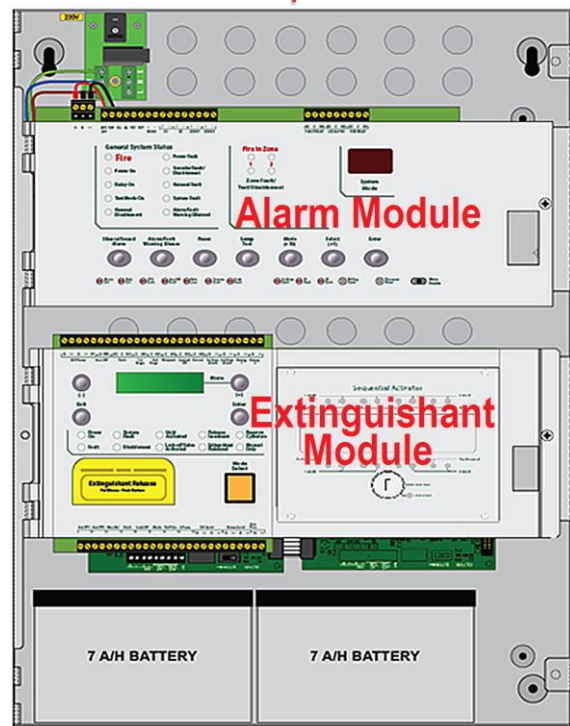

SYSTEM INOPERATIVE

FIRE ALARM EVACUATE AREA


FIRE ALARM EVACUATE AREA

FIRE ALARM DO NOT ENTER

FIRE ALARM DO NOT ENTER



MONITOR / DISABLE VIA AUTO-DIALER

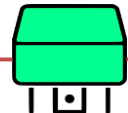

- Notes :
1. Fire Indicator Panel - Sigma XT Conventional - 2 Detection Zones - M3 Cabinet
 2. Power to FIP 230v AC
 3. FIP reorts back to Admin FIP via Zone 3
 4. Auto-Dialer Model S270
 5. Auto-Dialer is located within the FIP Cabinet.

	FIRE ALARM
	SIREN / STROBE
	90°C & RoR THERMAL DETECTOR
	PHOTO ELECTRIC SMOKE DETECTOR
	TEMPERATURE & HUMIDITY SENSOR
	RELAY FOR AC SHUTDOWN
	FIREPRO GENERATOR - 1200g
	FIREPRO GENERATOR - 2000g
	FIREPRO GENERATOR - 3000g
	FIREPRO GENERATOR - 5700g
	SIGN - FIRE ALARM / DNE
	SIGN - SYSTEM INOPERATIVE
	SIGN - FIRE ALARM / EVAC AREA
	AUTO DIALER
	AIR CONDITIONER

FIRE SAFETY EQUIPMENT PTY LTD

Drawn By	Title	Drawing No
PM	GIZO Exchange	TS-G1
Date		
02-05-19		